


VPM - MURAL WALLS

Note: electrical junction box provided for accent lighting/signage

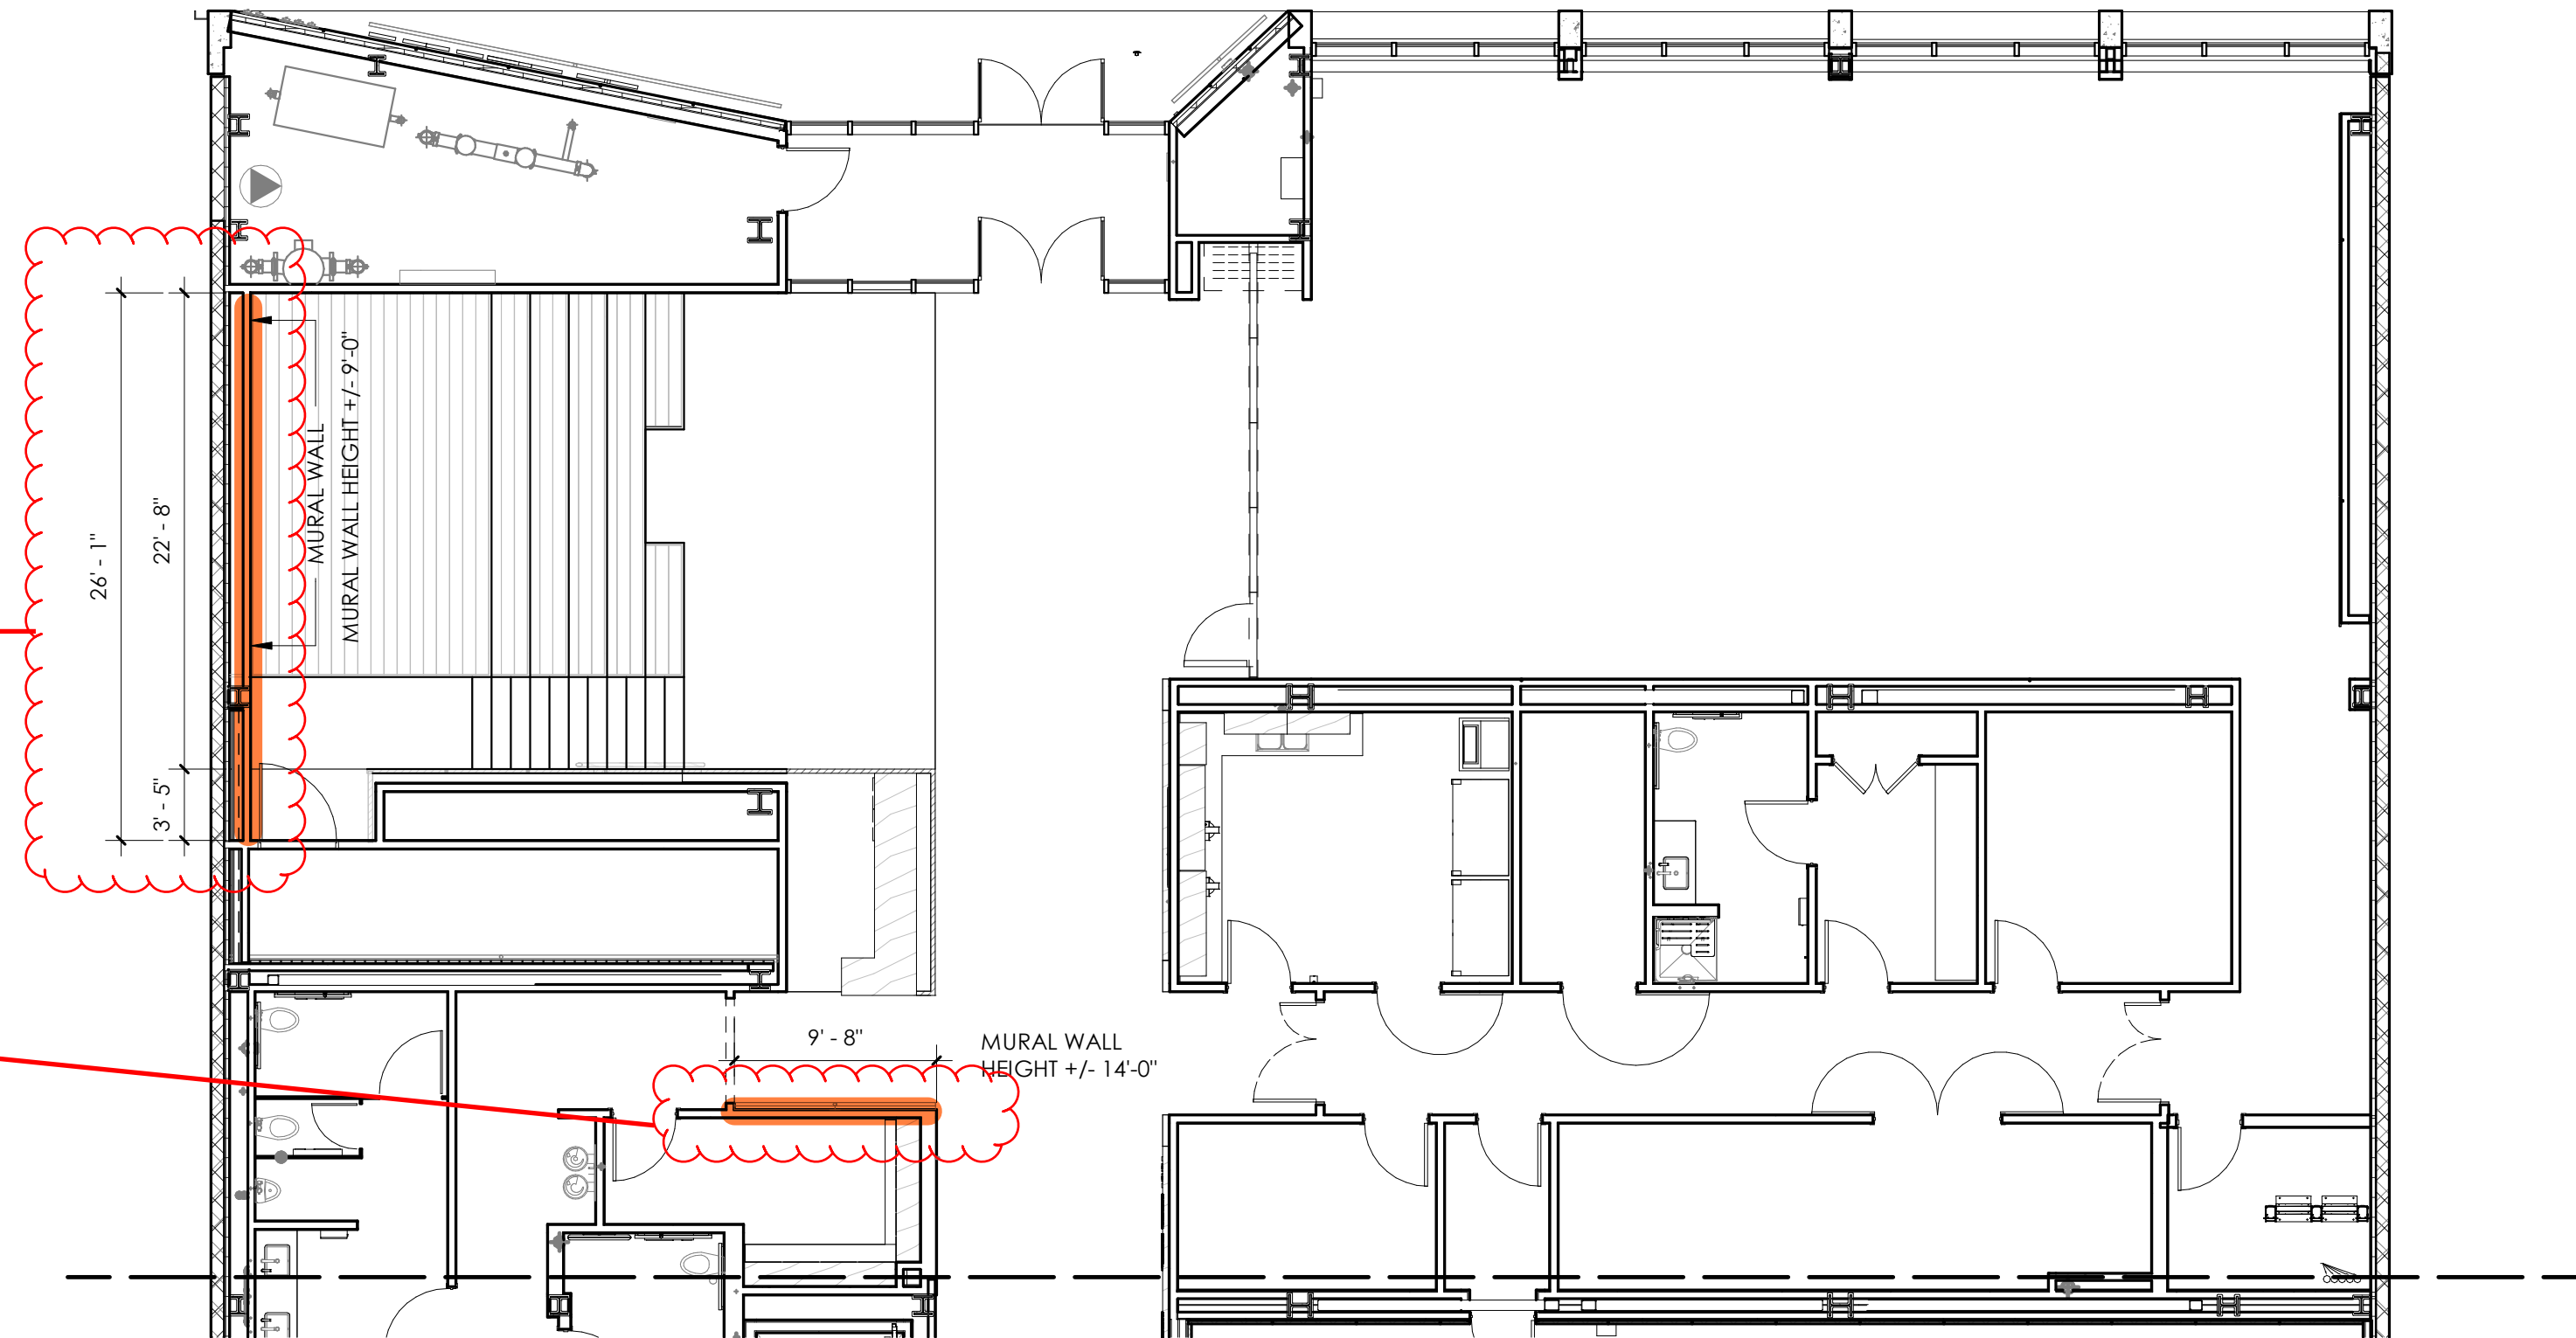

DIMENSIONS ARE APPROXIMATE
VERIFY AS-BUILT DIMENSIONS IN FIELD

1/4" = 1'